

Clarification in regards to Quires / Suggestion received for Bid Document

Date: 28/06/2021





Tender Notice No. : HITES/FM/JIPMER/ELE/2021-22/003 Dated: 11.06.2021

Tender for : “Supply, Installation, Testing and Commissioning of 110/22KV HT vacuum Circuit Breaker (VCB) Outdoor Panels at Phase - I Building Substation - II and Phase - II Building Substation - II, JIPMER, Puducherry.”

Sl No	Bidders Query	HITES Reply
1	Please also clarify BOQ of both the tenders' i.e Tender Notice No. : HITES/FM/JIPMER/ELE/2021-22/003 Dated: 11.06.2021 and Tender Notice No. : HITES/FM/JIPMER/ELE/2021-22/004 Dated: 11.06.2021 are exactly same. Please clarify is the BOQ of both the tenders same	Tender HITES/FM/JIPMER/ELE/2021-22/003 Dated: 11.06.2021 cancelled and Revised tender uploaded
2	Clause (a) of Eligibility criteria which states Firm should have A Grade license (EA) or above the EA grade licensed vendor with registered office at Puducherry or Chennai. We would like to mention here that we have A class electrical license of Madhya Pradesh and our working with same PAN India with NPCIL, NTPC and other electricity boards. We are working with Govt. of Puducherry also with endorsement of license at Puducherry. (License attached for your reference)	As per the tender eligibility criteria, If the Vendor have Electrical A Grade (EA) License or above the EA grade licensed with registered office at Puducherry or Chennai should apply. If vendor does not have registered office at Puducherry or Chennai and A grade license from Puducherry or Chennai should not qualify for the tender. Your endorsed license is acceptable, if your company does not have registered office at Puducherry or Chennai should not qualify for the bid.
3	TERMS OF PAYMENTS TO THE CONTRACTOR is not stated clearly i.e against supply how much payment will be made and what's the time period within which the balance payment will be released	<ul style="list-style-type: none"> a) Running account bill can be claimed against 70% supply, 20 % Erection and 10% commissioning. b) Payment shall be released only after Client approval and release of payment c) Payment shall be made within 60 days.
4	It is seen that Phase-II Building Substation-I Item No:1.3,1.4 have 2 different VCB panel i.e. Crompton Greaves and ABB make, whether contractor can consider System Control as make for those Items as a list of approved make	Tender HITES/FM/JIPMER/ELE/2021-22/003 Dated: 11.06.2021 cancelled and Revised tender uploaded. Supply of outdoor VCB panel, bidder are allowed to supply any one make from the make list (CG, ABB, System Control or L&T) and Should not allow to mix different make.




5	It found that 22KV 3CX240 Sqmm XLPE(E) Al Ar in the list of approved material and scope of work mentioned in the line item is supply & erection, which is missing in the list of Volume-V BOQ/ Price Bide, Kindly Clarify As same as serial No:3 from the list of approved makes	Tender HITES/FM/JIPMER/ELE/2021-22/003 Dated: 11.06.2021 cancelled and Revised tender uploaded
6	Technical Specification Scope of work locations are Mismatching as against BOQ/Price bide	Tender HITES/FM/JIPMER/ELE/2021-22/003 Dated: 11.06.2021 cancelled and Revised tender uploaded
7	The Schematic diagram for the proposed installation shall be shared.	Schematic diagram enclosed as Annexure
8	GST prevailing at the rate of 18% is covered as against 12% as indicated in BOQ.	Composite supply of works contract as defined in clause (119) of section 2 of the Central Goods and Services Tax Act, 2017, supplied to the {Central Government, State Government, Union territory, a local authority, a Governmental Authority or a Government Entity} by way of construction, erection, commissioning, installation, completion, fitting out, repair, maintenance, renovation, or alteration GST is 12% and Vendors can take input credit
9	We currently have our Head office at Faridabad, Haryana and have an Electrical A Grade (EA) License of Chhattisgarh & Assam but we will obtain Electrical A Grade (EA) License and will have registered office in Puducherry or Chennai after the award of the contract. Kindly provide your confirmation on the same.	As per the tender eligibility criteria, If vendor does not have registered office at Puducherry or Chennai and A grade license from Puducherry or Chennai should not qualify for the tender. Bidders are advised to possess the above eligibility while applying.
10	L&T make VCBs are approved by HITES & CPWD in their projects. Relevant approval page is attached for your ready reference request you to approve L&T VCB & VCB panels also for these project also	Tender HITES/FM/JIPMER/ELE/2021-22/003 Dated: 11.06.2021 cancelled and Revised tender uploaded. L&T make considered in the revised tender

LOCATION: SS-2 HT PANEL ROOM

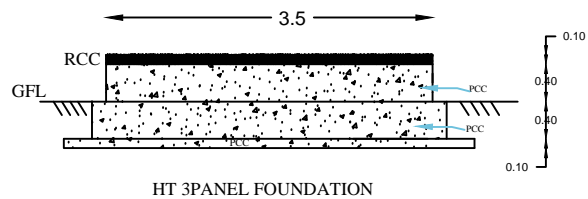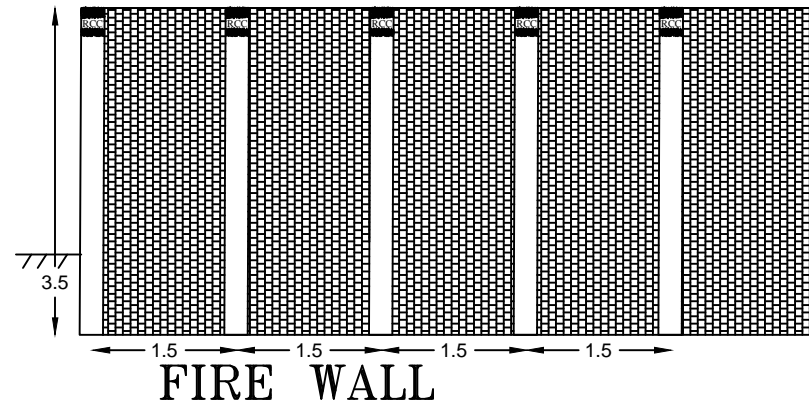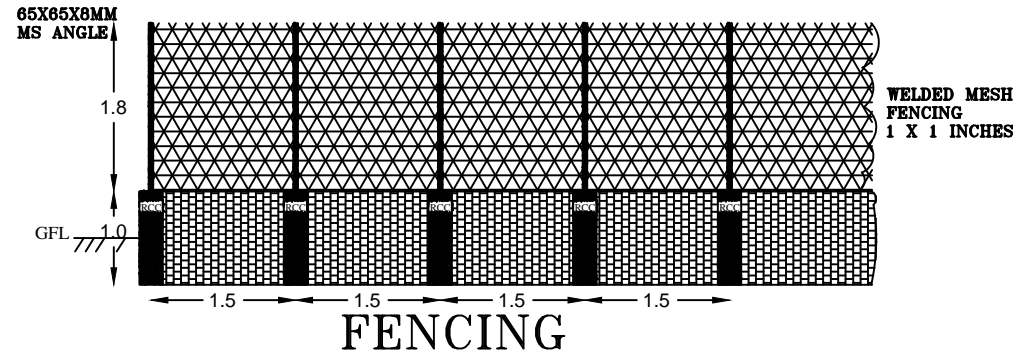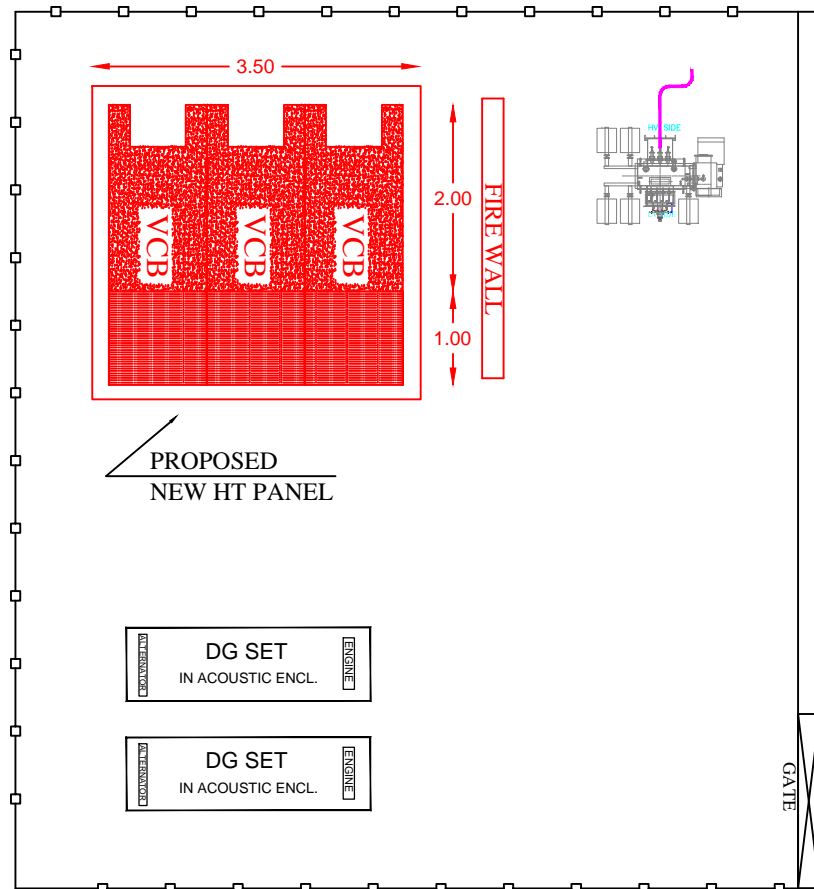

REV.	DATE	DR.N.	CHD.	AP.D.	DESCRIPTION
SCALE:	LOCATION: SS-2 HT ROOM			PROJECT No.	
CLIENT:					
M/s. JIPMER., Puducherry.					
CONTRACTOR:					
DRG. TITLE: VCB & RMG FOUNDATION DWG					
DRG.No.	01	-	-	2020	001
AREA	P/AREA	DOC. CODE	YEAR	SHT	OF SHT

LOCATION: PHASE-II SS-2 HT PANEL ROOM

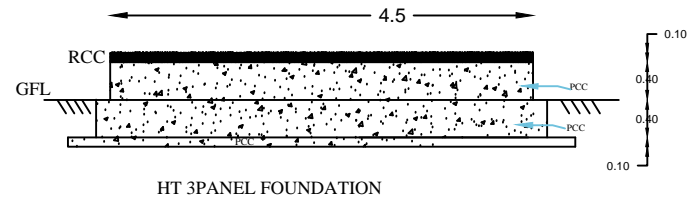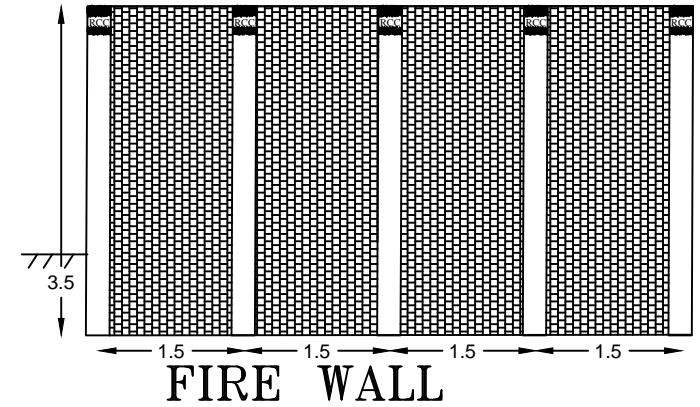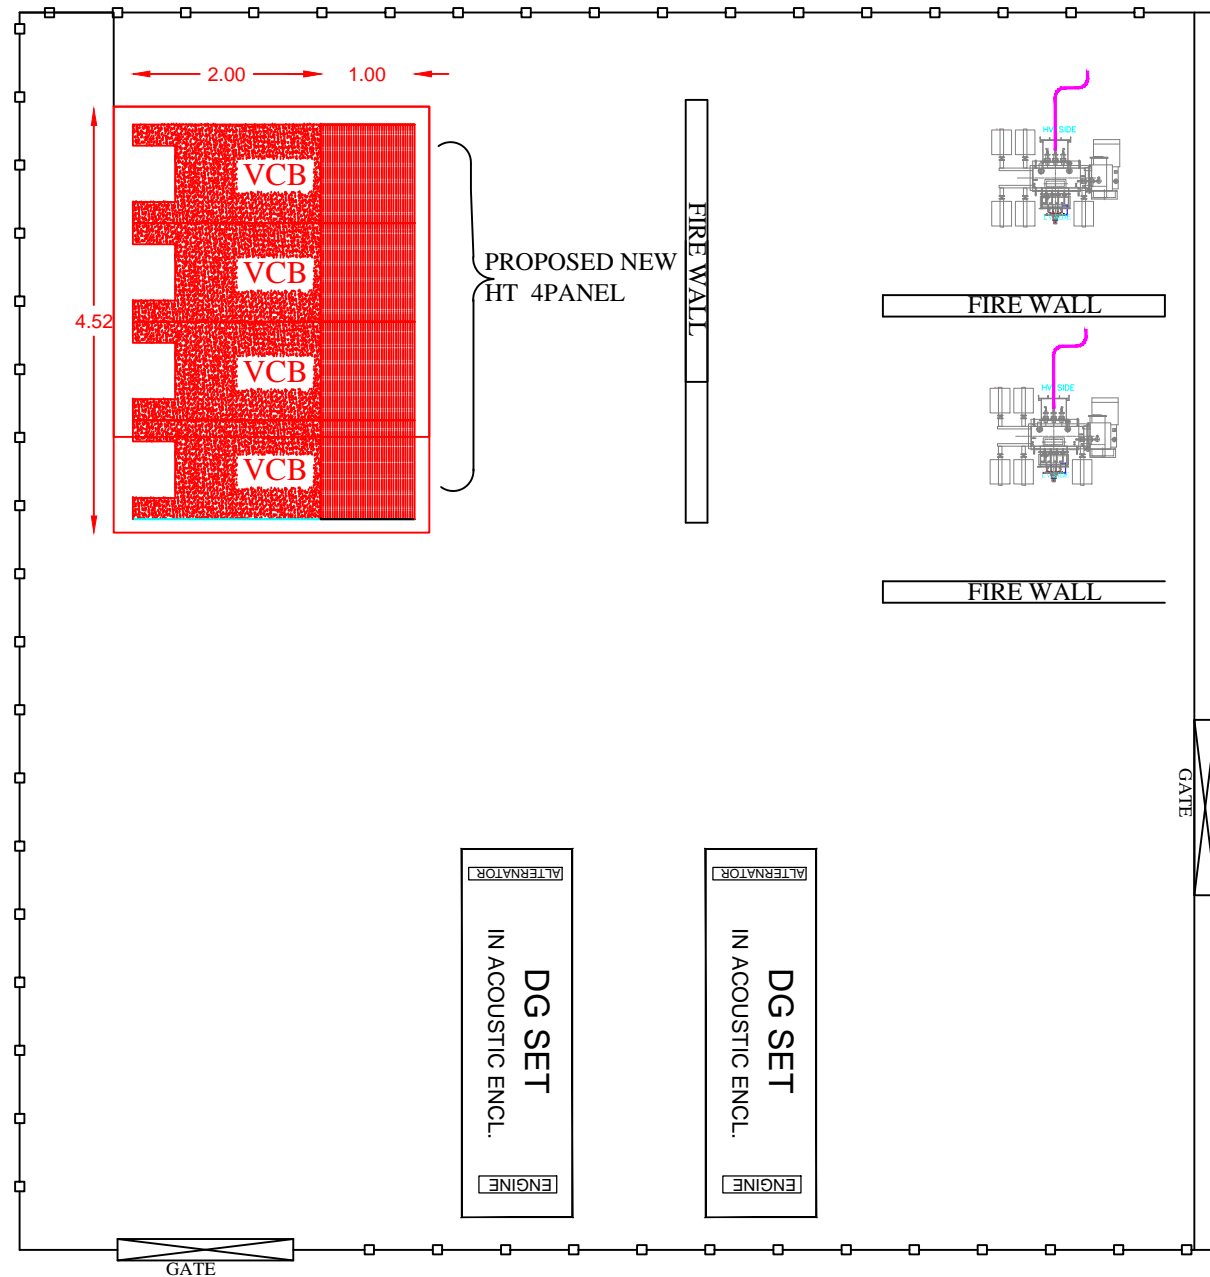

	11/11/2020				
REV.	DATE	DR.N.	CH'D.	AP'D.	DESCRIPTION
SCALE:		LOCATION: SS-2 HT ROOM		PROJECT No.	
CLIENT:					
M/s. JIPMER., Puducherry.					
CONTRACTOR:					
DRG. TITLE: VCB & RMG FOUNDATION DWG					
DRG.No.	01	-	-	2020	001
AREA	P/AREA	DOC. CODE	YEAR	SHT	OF SHT